

APPLICATION FOR CERTIFICATE OF APPROPRIATENESS (COA)

Building address 220 E 3rd St. Bethlehem PA 18015
Owner of building Kevin Luna Phone
Owner's email & mailing address 220/230 E 3rd St. Bethlehem PA 1801
Applicant Xi Cheng Phone:
Applicant's email & mailing address 6577 Heidelberg Ct. Orefield PA 1506
Street and Number City State Zip Code

APPLICANT MUST ATTEND MEETING FOR CASE TO BE HEARD.
USE THE CHECKLIST ON THE BACK OF THIS APPLICATION TO ENSURE YOUR SUBMISSION IS COMPLETE.

Historic & Architectural Review Board - Application form, photographs, and drawings must be submitted 2 weeks prior to the regular scheduled meeting in order to be placed on the agenda for the next meeting.

South Bethlehem & Mount Airy Historic Conservation Commission - Application form, photographs, and drawings must be submitted 2 weeks prior to the regular scheduled meeting in order to be placed on the agenda for the next meeting.

1. PHOTOGRAPHS - Photographs of your building and neighboring buildings must accompany your application.


2. TYPE OF WORK PROPOSED - Check all that apply. Please bring any samples or manufactures specifications for products you will use in this project.
Trim and decorative woodwork
Siding and Masonry
Roofing, gutter and downspout
Windows, doors, and associated hardware
Storm windows and storm doors
Shutters and associated hardware
Paint (Submit color chips - HARB only)
Skylights
Metal work
Light fixtures
Signs
Demolition
Other

3. DRAWINGS OF PROPOSED WORK - Required drawings must accompany your application. Please submit ONE ORIGINAL AND TEN (10) COPIES OF DRAWINGS, PHOTOGRAPHS, APPLICATION FORM, AND ANY SPECIFICATIONS
Alteration, renovation, restoration (1/4 or 1/8"=1'0" scale drawings required IF walls or openings altered.)
New addition (1/4" or 1/8"=1'0" scale drawings: elevations, floor plans, site plan)
New building or structure (1/4" or 1/8"=1'0" scale drawings: elevations, floor plans, site plan)
Demolition, removal of building features or building (1/4" or 1/8"=1'0" scale drawings: elevation of remaining site and site plan)
A scale drawing, with an elevation view, is required for all sign submittals

4. DESCRIBE PROJECT - Describe any work checked in #2 and #3 above. Attach additional sheets as needed.
Install sign.



5. APPLICANT'S SIGNATURE Xi Cheng DATE: 02/22/2021
6. OWNER'S SIGNATURE Kevin Luna DATE: 02/24/21

CLEAR ANODIZED ALUMINUM BOX

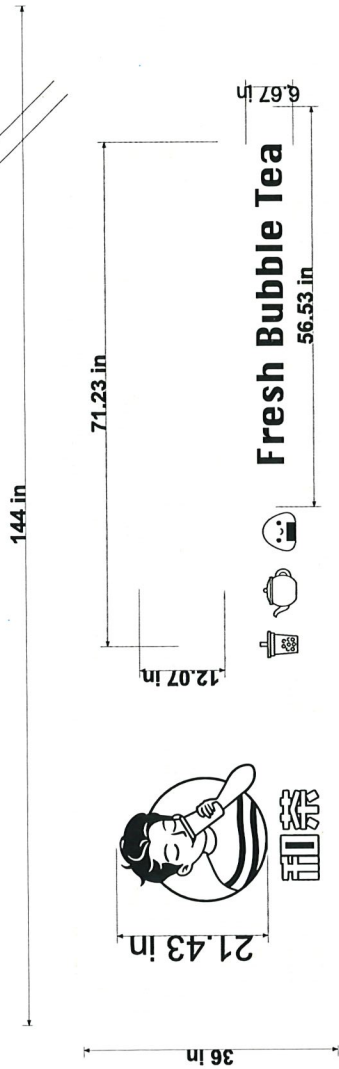

21"X26.6" ILLUMINATED CHANNEL LETTER

- * 22" INDIVIDUAL CHANNEL LETTER
- * 144" X 36" X 3" GRAY BACKER PANEL
- * 0.040 WHITE ALUMINUM RETURN
- * 1" WHITE PLEXI TRIM-CAP
- * 3/16 WHITE PLEXI & WHITE LED
- * W . U/L LISTED
- * TRANSFORMER WILL BE CONCEALED

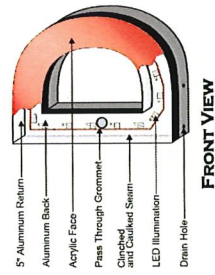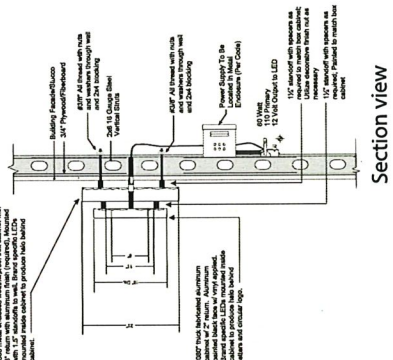

Customer: _____
 Company: _____
 Address: _____
 City: _____ State/ZIP: _____
 Phone: _____
 Fax: _____

CHENLIN GRAPHIC & DESIGN
32 ALLEN ST
NEW YORK NY 10002
646-449-8710

Job No.: _____ Date: 2021/1/18
 Order Date: _____ Salesperson: _____
 Sign Dimensions: _____ Estimate: _____
 Comments: _____

duce Deli Fish





cricket

principle

UID: 70106144

Client: Cricket

Project: Cricket Exterior Conversion

Title: Exterior Signage

Site address: 220 E 3rd Street
Bethlehem, PA

Project manager: Maggie Solon

Drawn by: LQG

Date: 01/15/15

Revision: 3

As the Owner/Lessor/Mortgage or Security interest holder, I hereby acknowledge and accept the installation of signs as illustrated within the renderings shown within this brand proposal. By signing below I consent to the installation of signs at the premises and property address listed within this brand proposal and acknowledge that I have reviewed all details of this brand proposal in its entirety.

Signature of (Owner/Lessor/Mortgage or Security Interest Holder)



Print Name

Date





Sign	Existing Sign	SF	Recommended Sign	SF
N-01	No Existing Sign	N/A	Halo Illuminated CR-FL-30B	27.71
N-02	No Existing Sign		AR-DV-SD Hours of Operation	

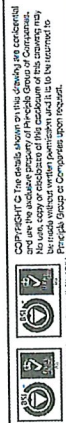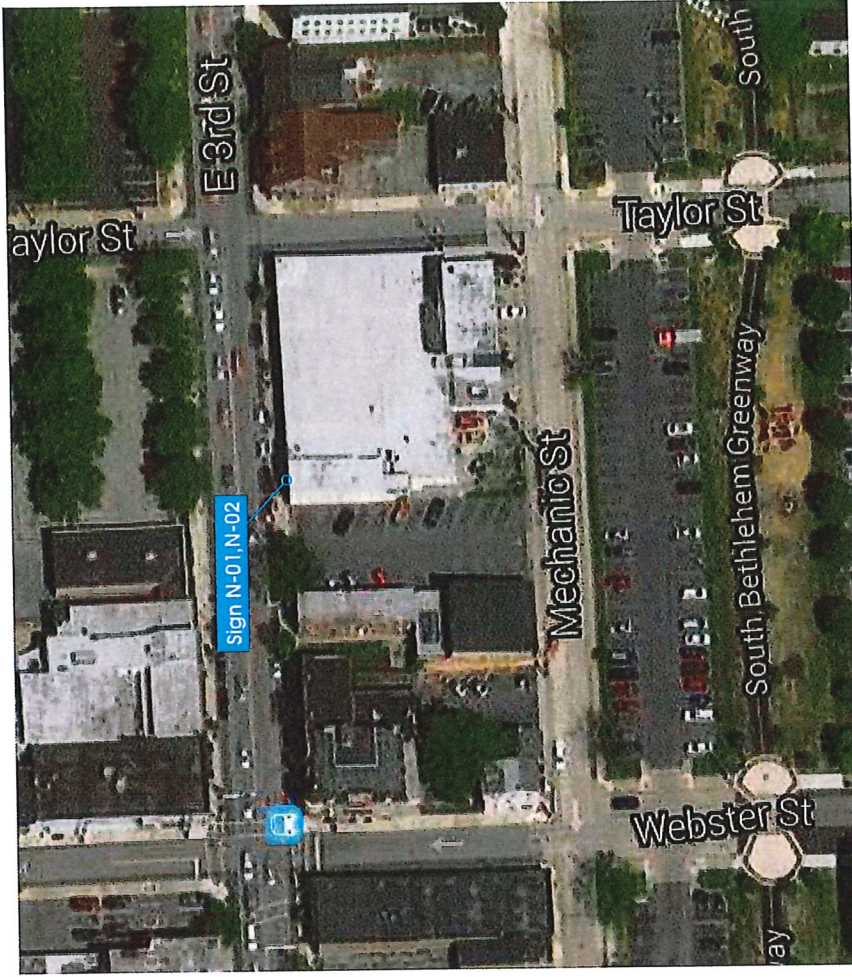

2035 Lakeside Centre Dr. Suite 250
 Knoxville, TN 37922
 T+865 692 4058 F+865 692 4104

Revision notes:
 Rev.1 - Proposed sign will need to be non-illuminated as code does not allow illuminated signs
 Rev.2 - Proposed sign will need to be halo illuminated
 Rev.3 - Reduced proposed sign to 30" letterset



Client:	Cricket	Drawn by:	LOG
Project:	As Built	Checked by:	-
Title:	LOG	Scale:	NTS
Date:	01.15.2015	Revision:	3
		Page:	3



EST 2012
COLONY
MEADERY

211
PULL

20
24 HOURS
TOW AWAY ZONE
NO PARKING
9 AM - 5 PM
TOW AWAY ZONE

SNOW EMERGENCY ROUTE
ANY OTHER LOCALS
NO PARKING
PUBLIC PROPERTY
TOW AWAY ZONE

NO PARKING
TOW AWAY ZONE