

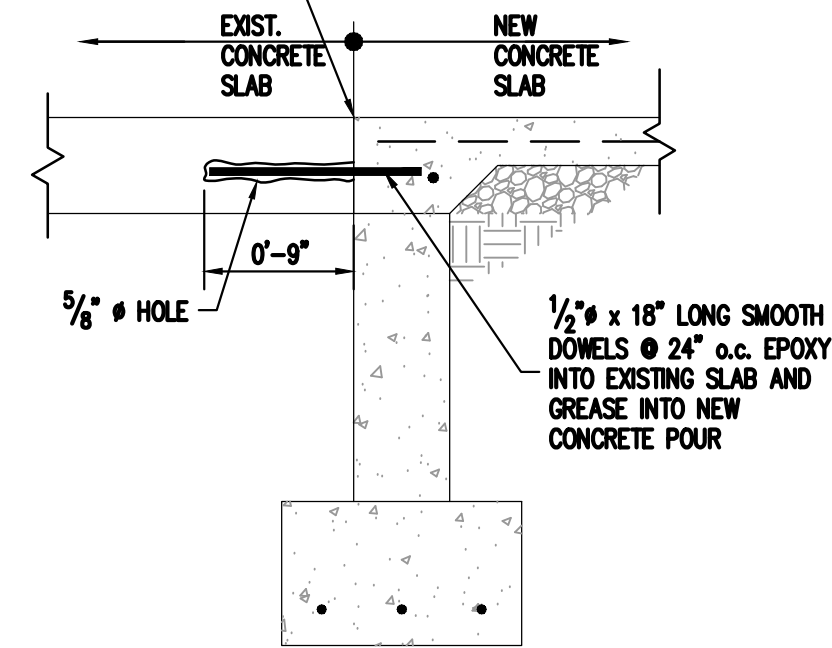



SAW CUT EXISTING SLAB  
PROVIDE BONDING AGENT  
(SIKADUR 32, HI-MOD OR  
APPROVED EQUAL) TO BOND  
OLD CONCRETE TO NEW

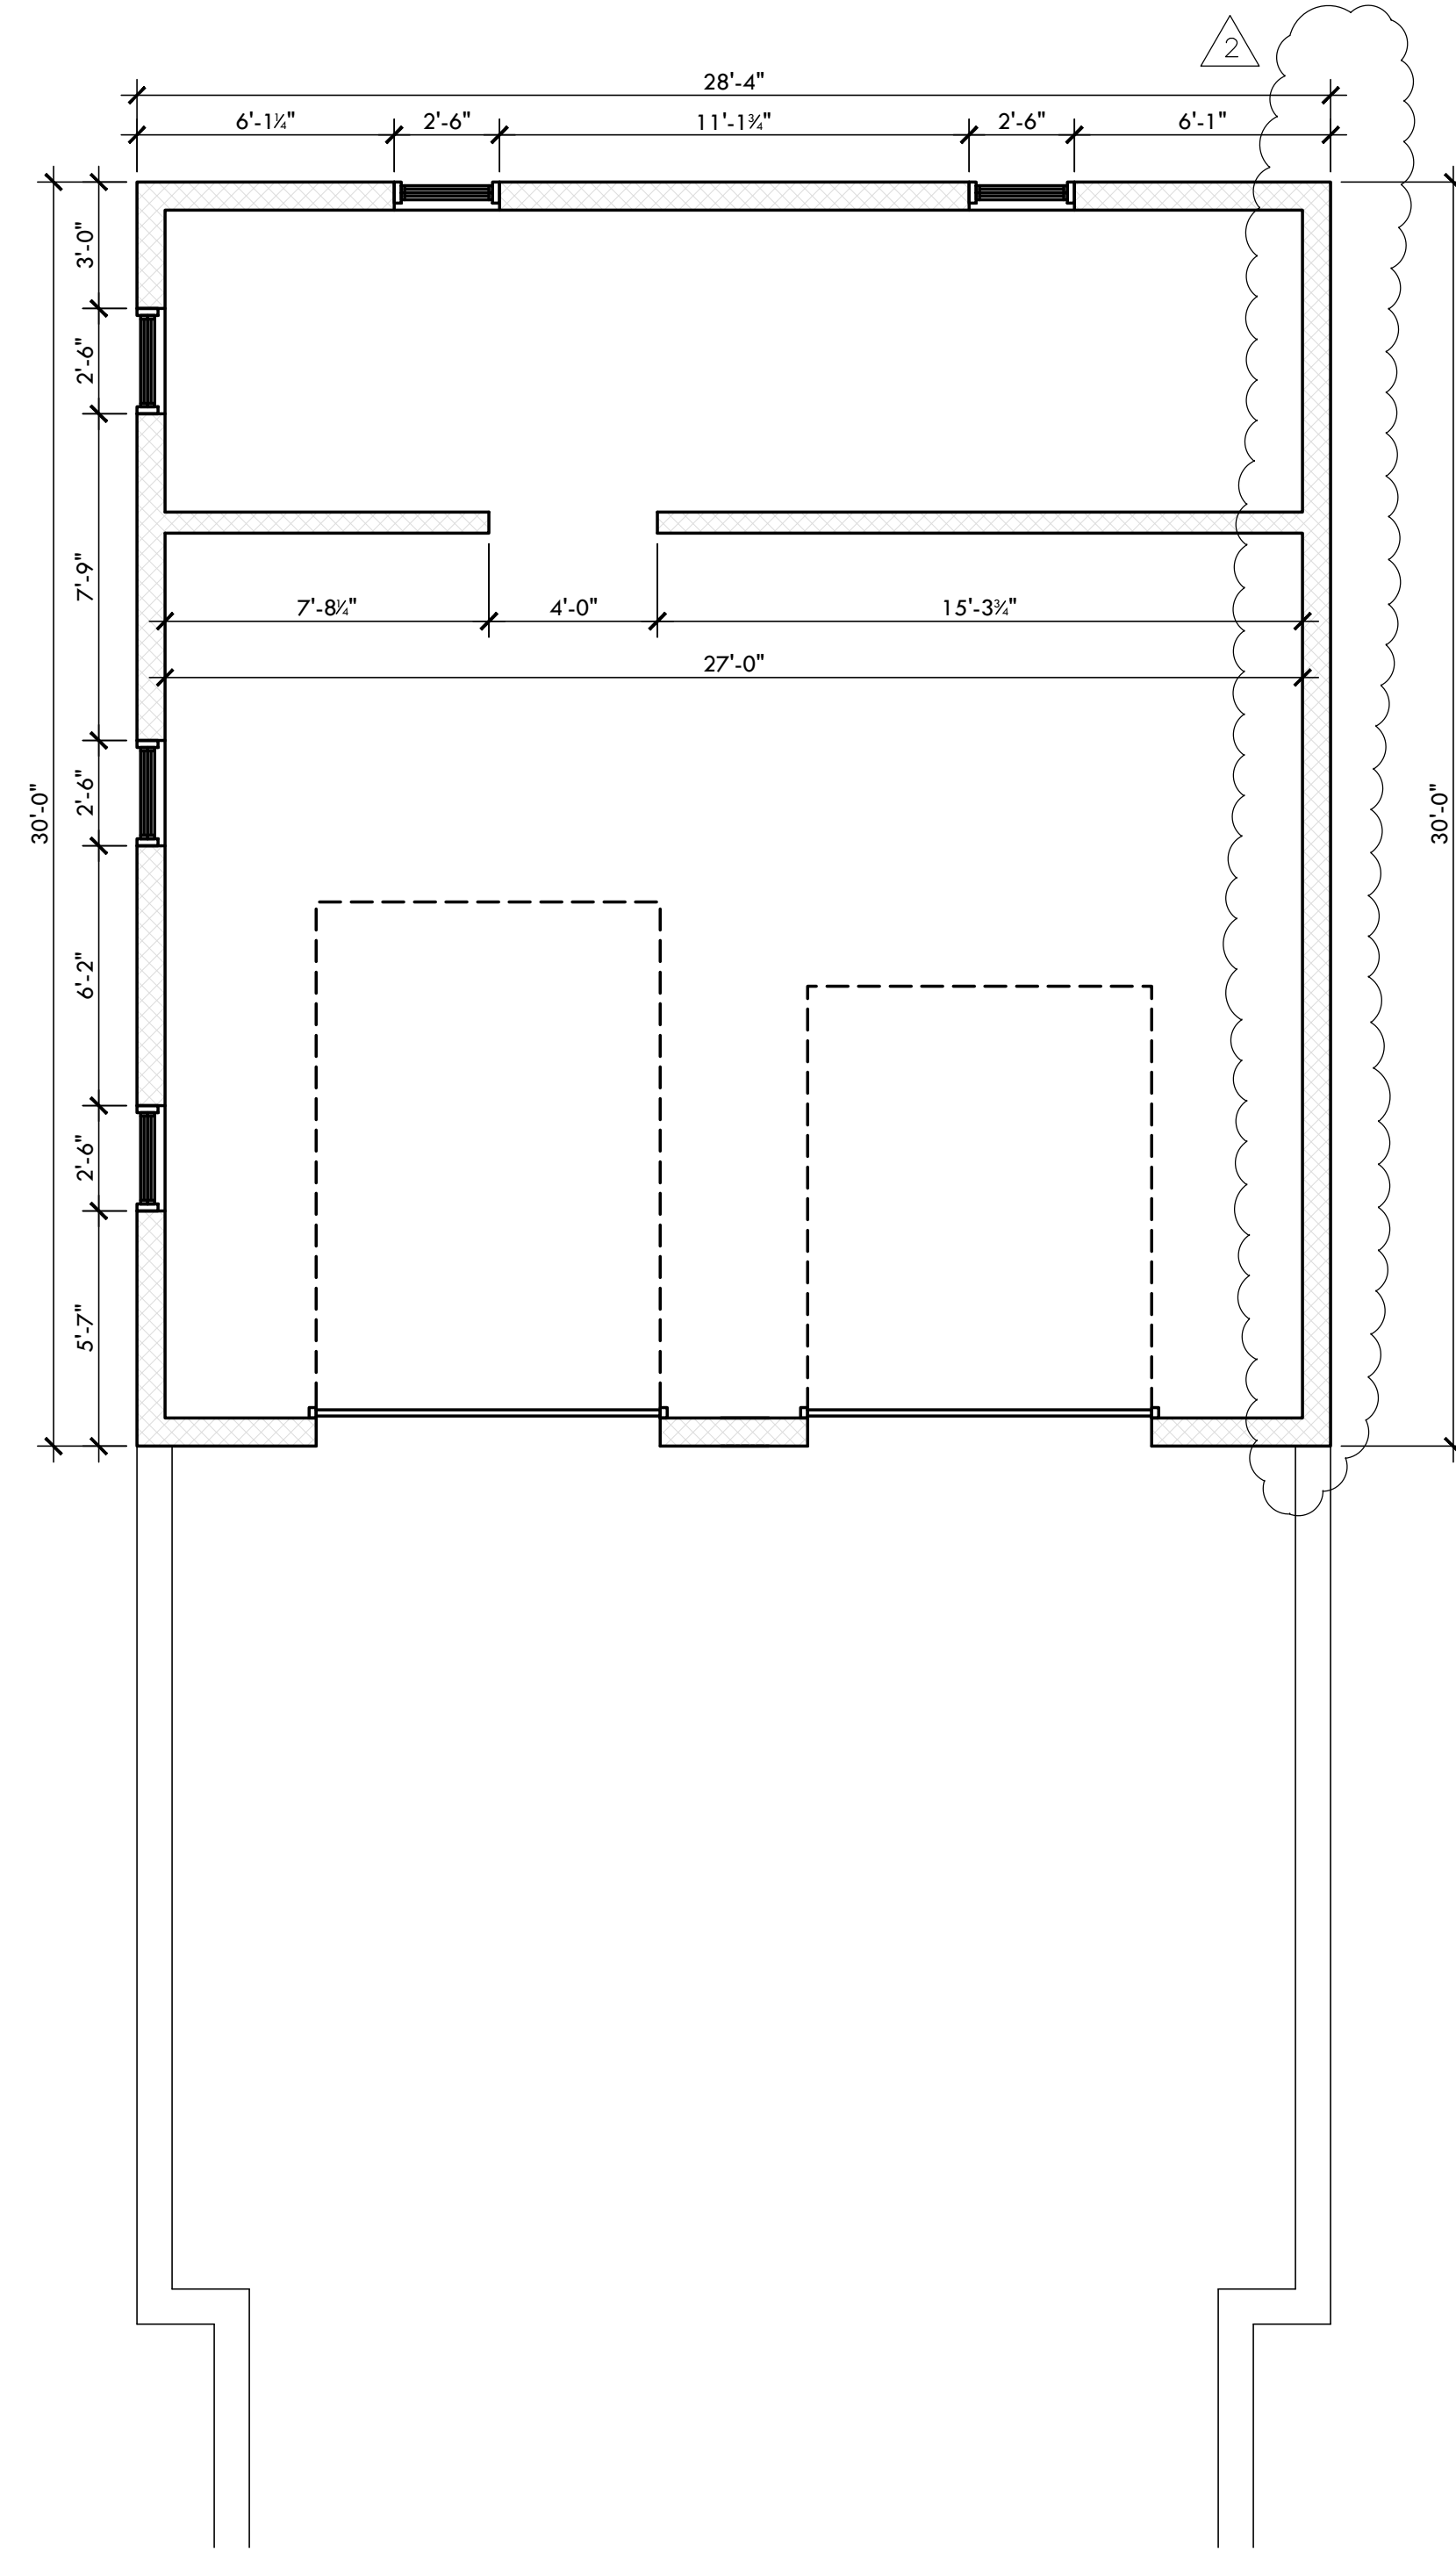


NOTE: DOWELS ARE NOT REQUIRED IF BOTH SLABS  
BEAR 4" (MIN.) ON A FOUNDATION WALL

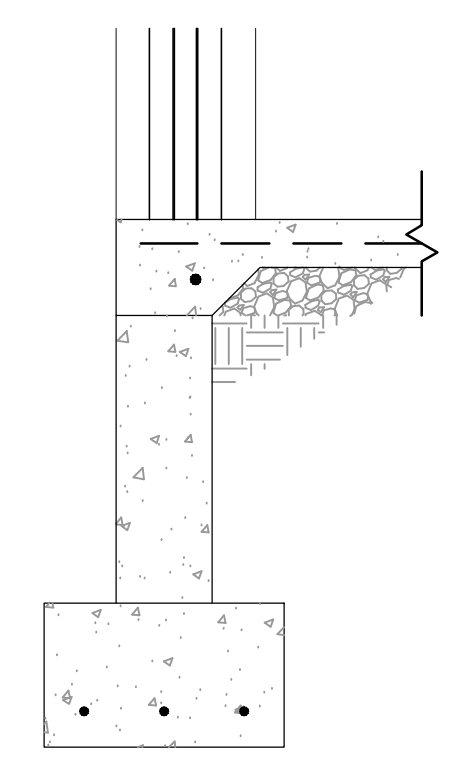

EXISTING FLOOR PLAN  
SCALE: 1/4" = 1' - 0"

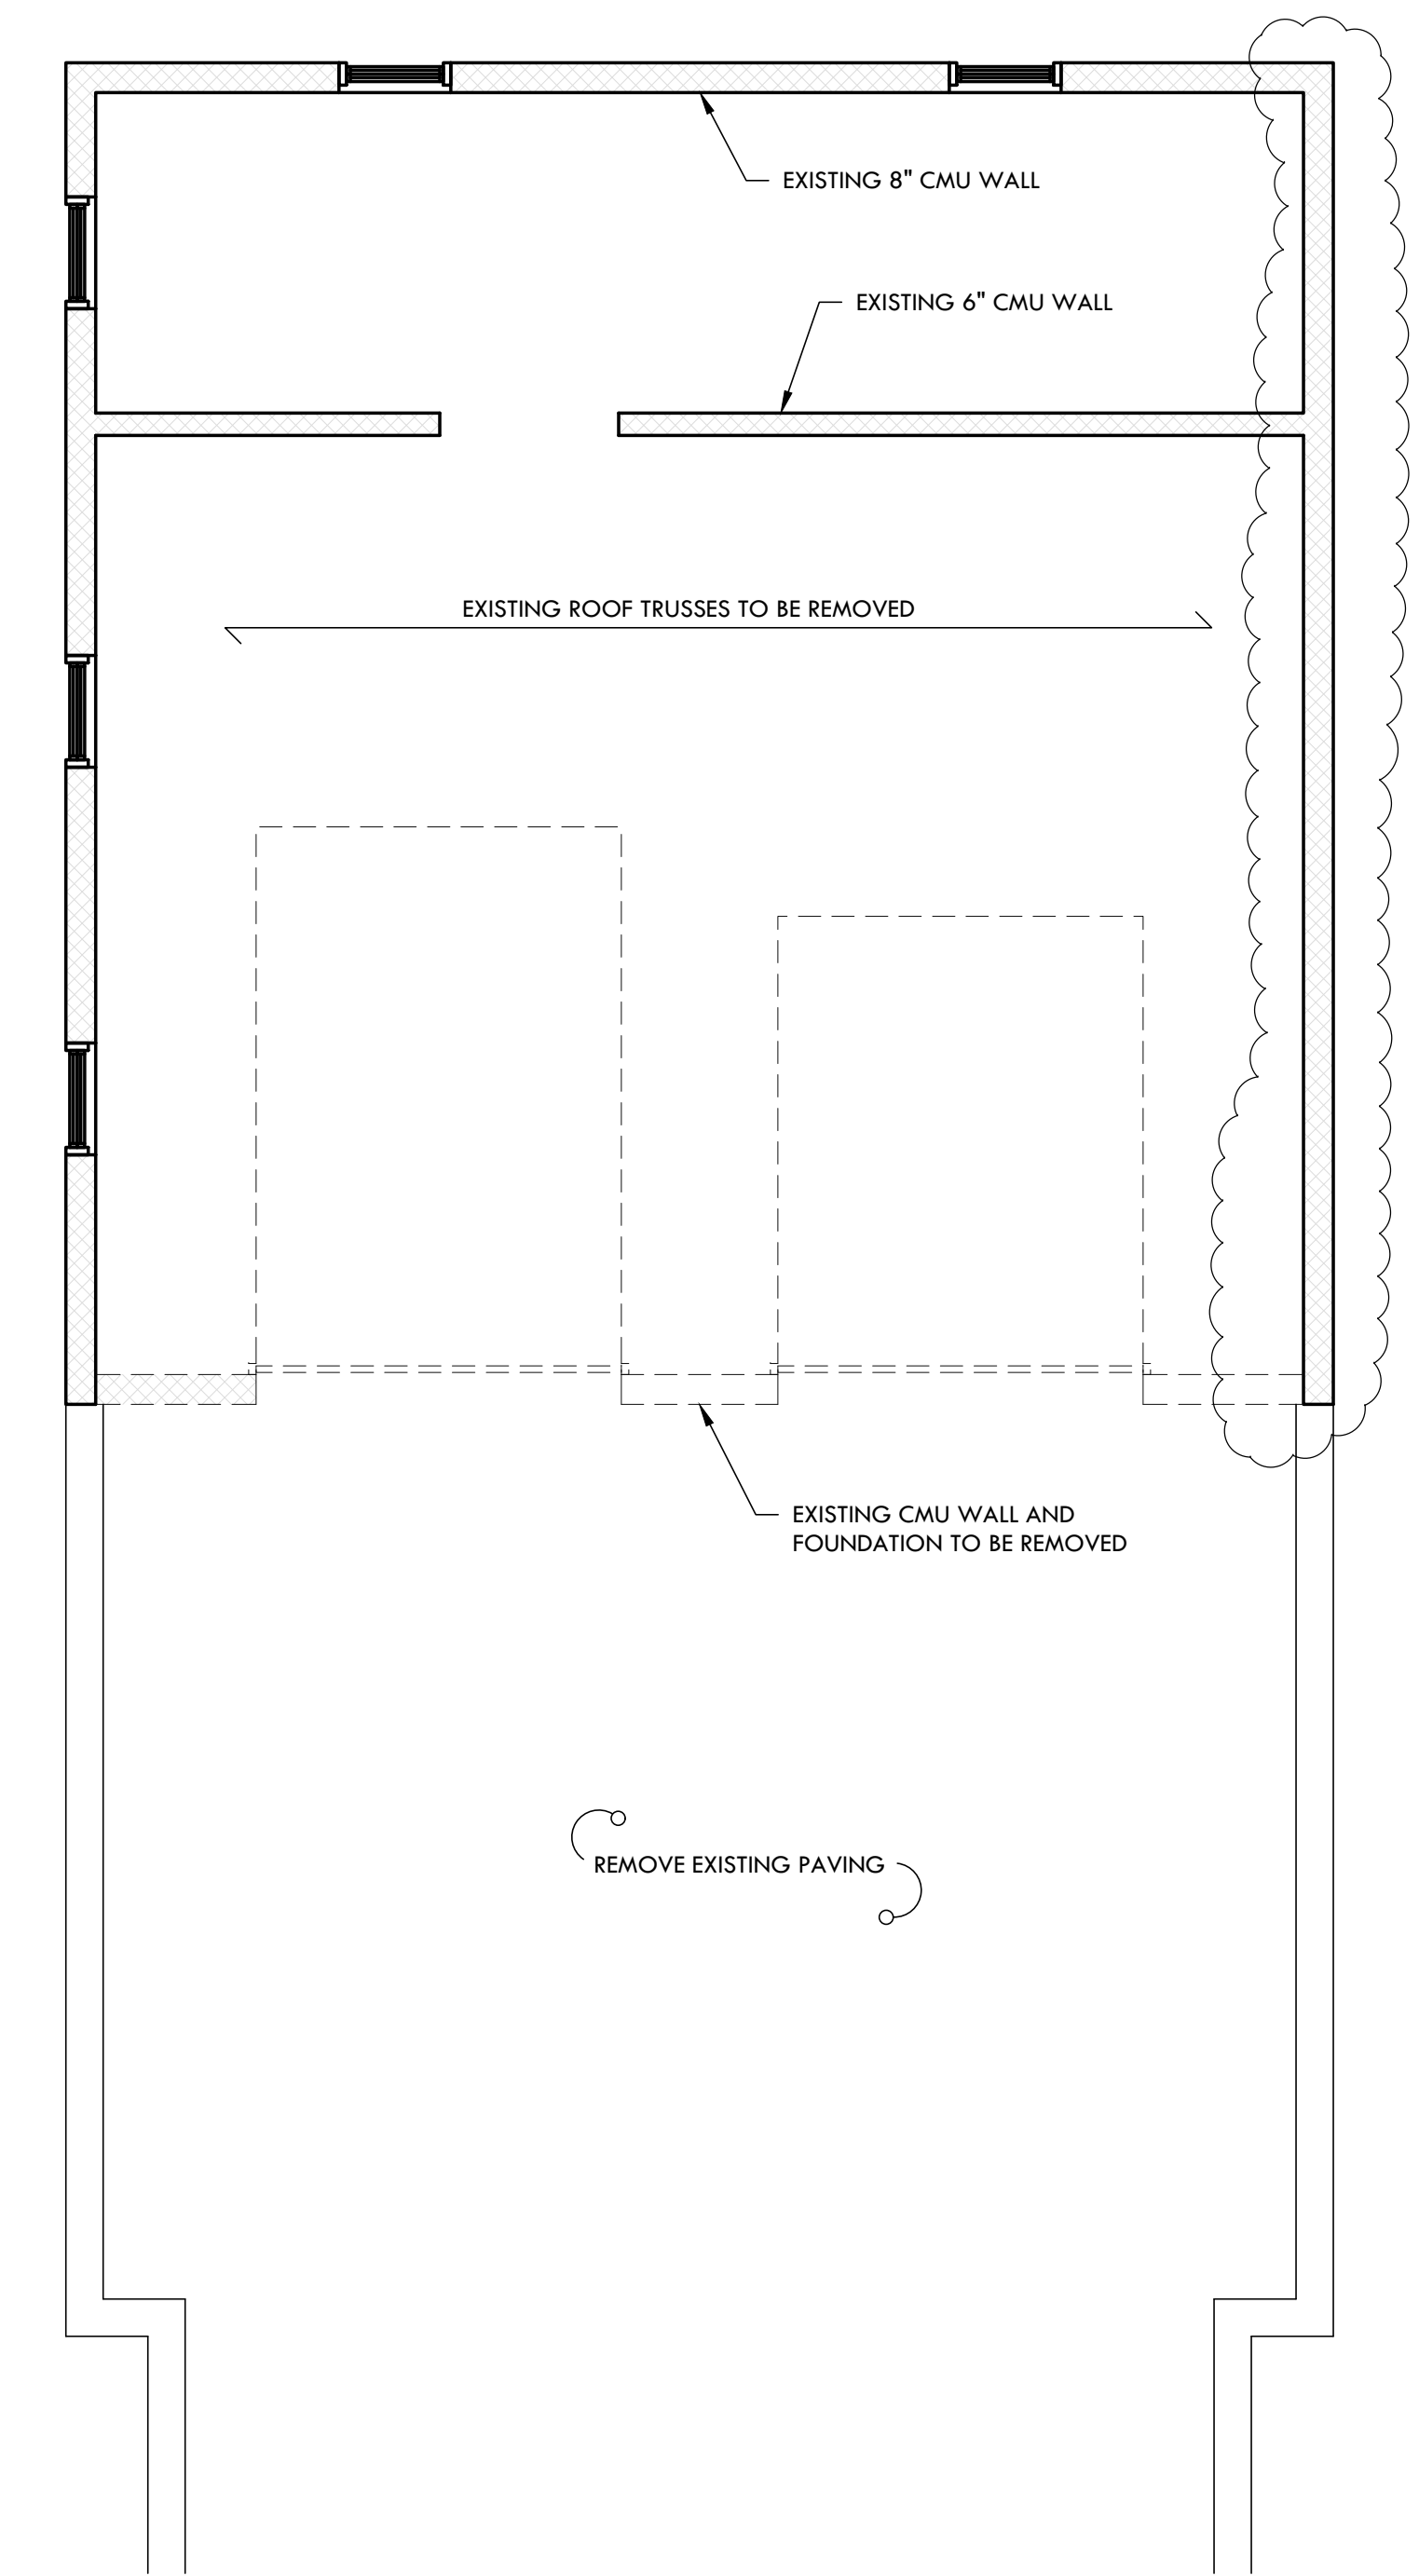

DEMOLITION PLAN  
SCALE: 1/4" = 1' - 0"

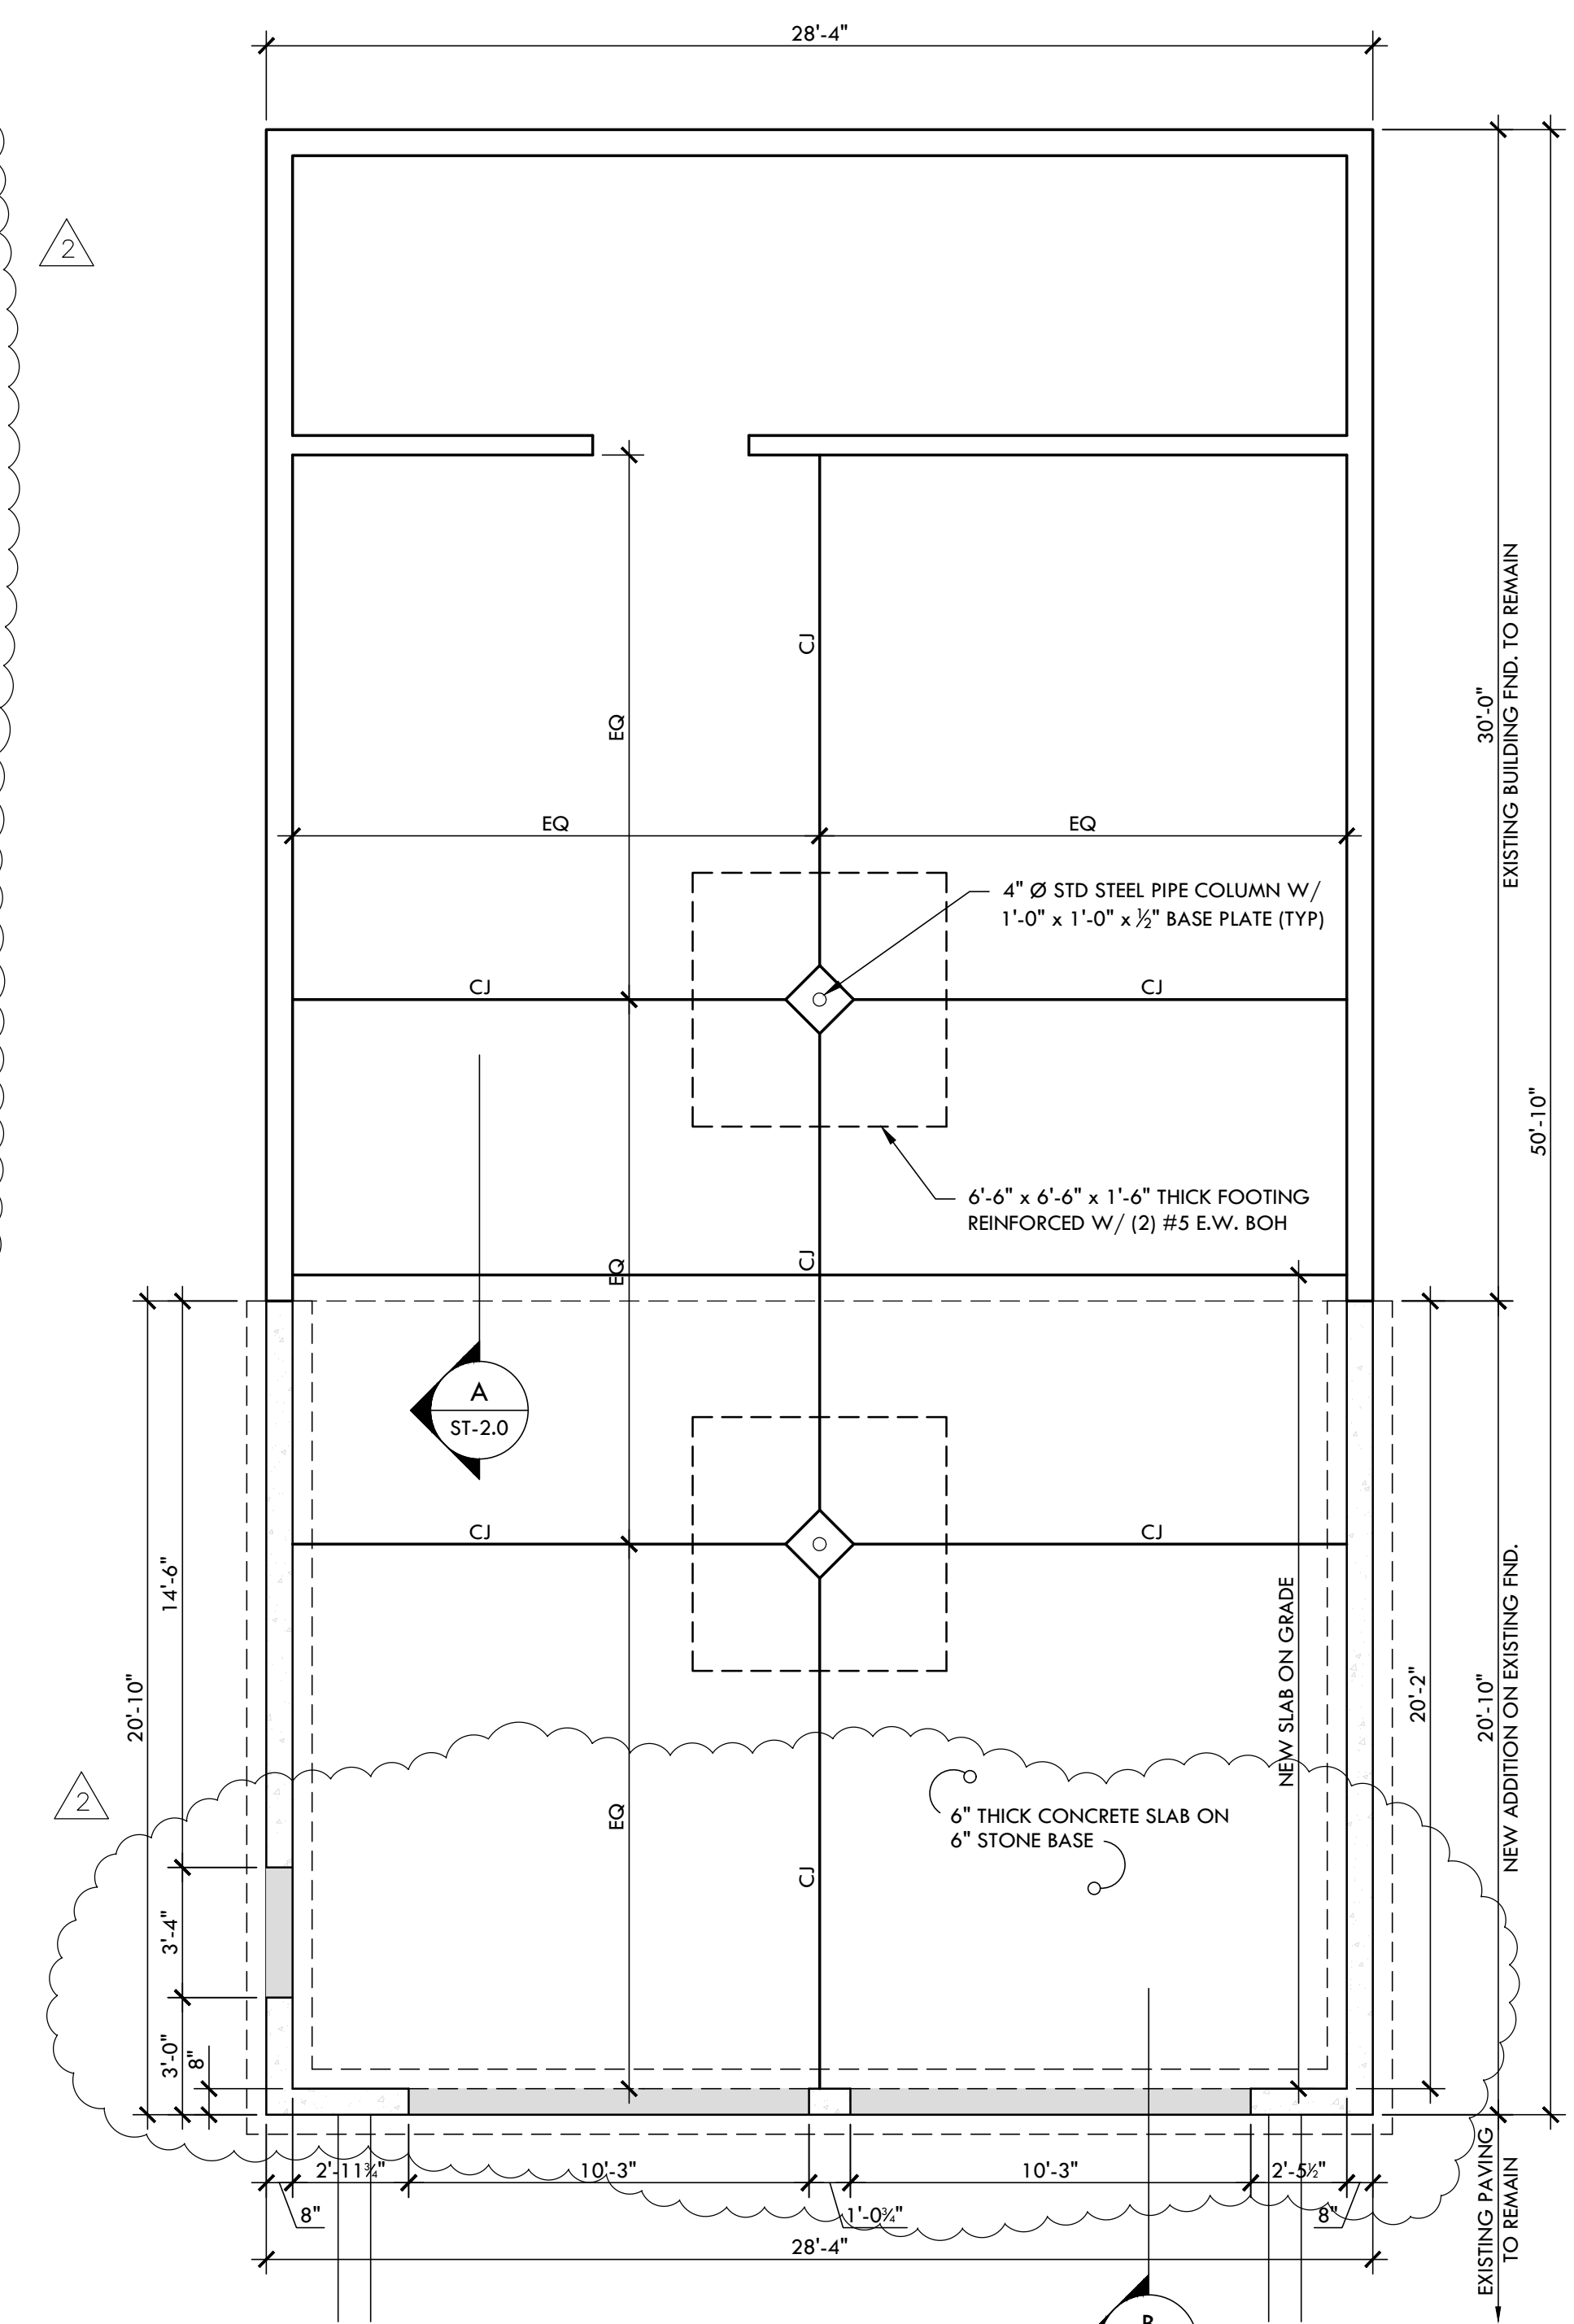

FOUNDATION PLAN  
SCALE: 1/4" = 1' - 0"

REV	DESCRIPTION	BY	CHK	DATE	REV	DESCRIPTION	BY	CHK	DATE
1	GENERAL REVISIONS REMOVED SECOND FLOOR	TZS	BAC	12/8/2021	2	PER CODE REVIEW COMMENTS	TZS	BAC	12/27/2021

**BASE ENGINEERING INC.**  
CONSULTING ENGINEERS & SURVEYORS  
1010 N. QUEBEC STREET  
ALLENTOWN, PA 18109  
PHONE: (610) 437-0978  
www.BaseEng.com  
email: BaseEngineering@BaseEng.com

SCALE	AS NOTED	WAREHOUSE GARAGE ADDITION FLOOR PLANS	DWG. No.
DATE			2021-103 ST2.0
DRAWN BY	TZS	709 YEATES STREET	REV. 2
CHECKED BY	BAC	BETHLEHEM, PA	SHEET
			2 of 6

C:\Users\BAC\OneDrive\Documents\BASE\2021-103 WAREHOUSE GARAGE ADDITION\2021-103-27 2021-103 WAREHOUSE GARAGE ADDITION.dwg, 9/20/2021 8:54 AM  
 THE INFORMATION AND CONTENT OF THIS PLAN OR DOCUMENT IS THE PROPERTY OF BASE ENGINEERING INC. ANY REPRODUCTION, USE, OR DISCLOSURE OF THE DESIGN OR DETAILS CONTAINED HEREIN IS PROHIBITED WITHOUT THE EXPRESSED WRITTEN AUTHORIZATION OF BASE ENGINEERING INC. COPYRIGHTED © 2008 BASE ENGINEERING INC.