


FIRST FLOOR PLAN
SCALE: 1/4" = 1' - 0"

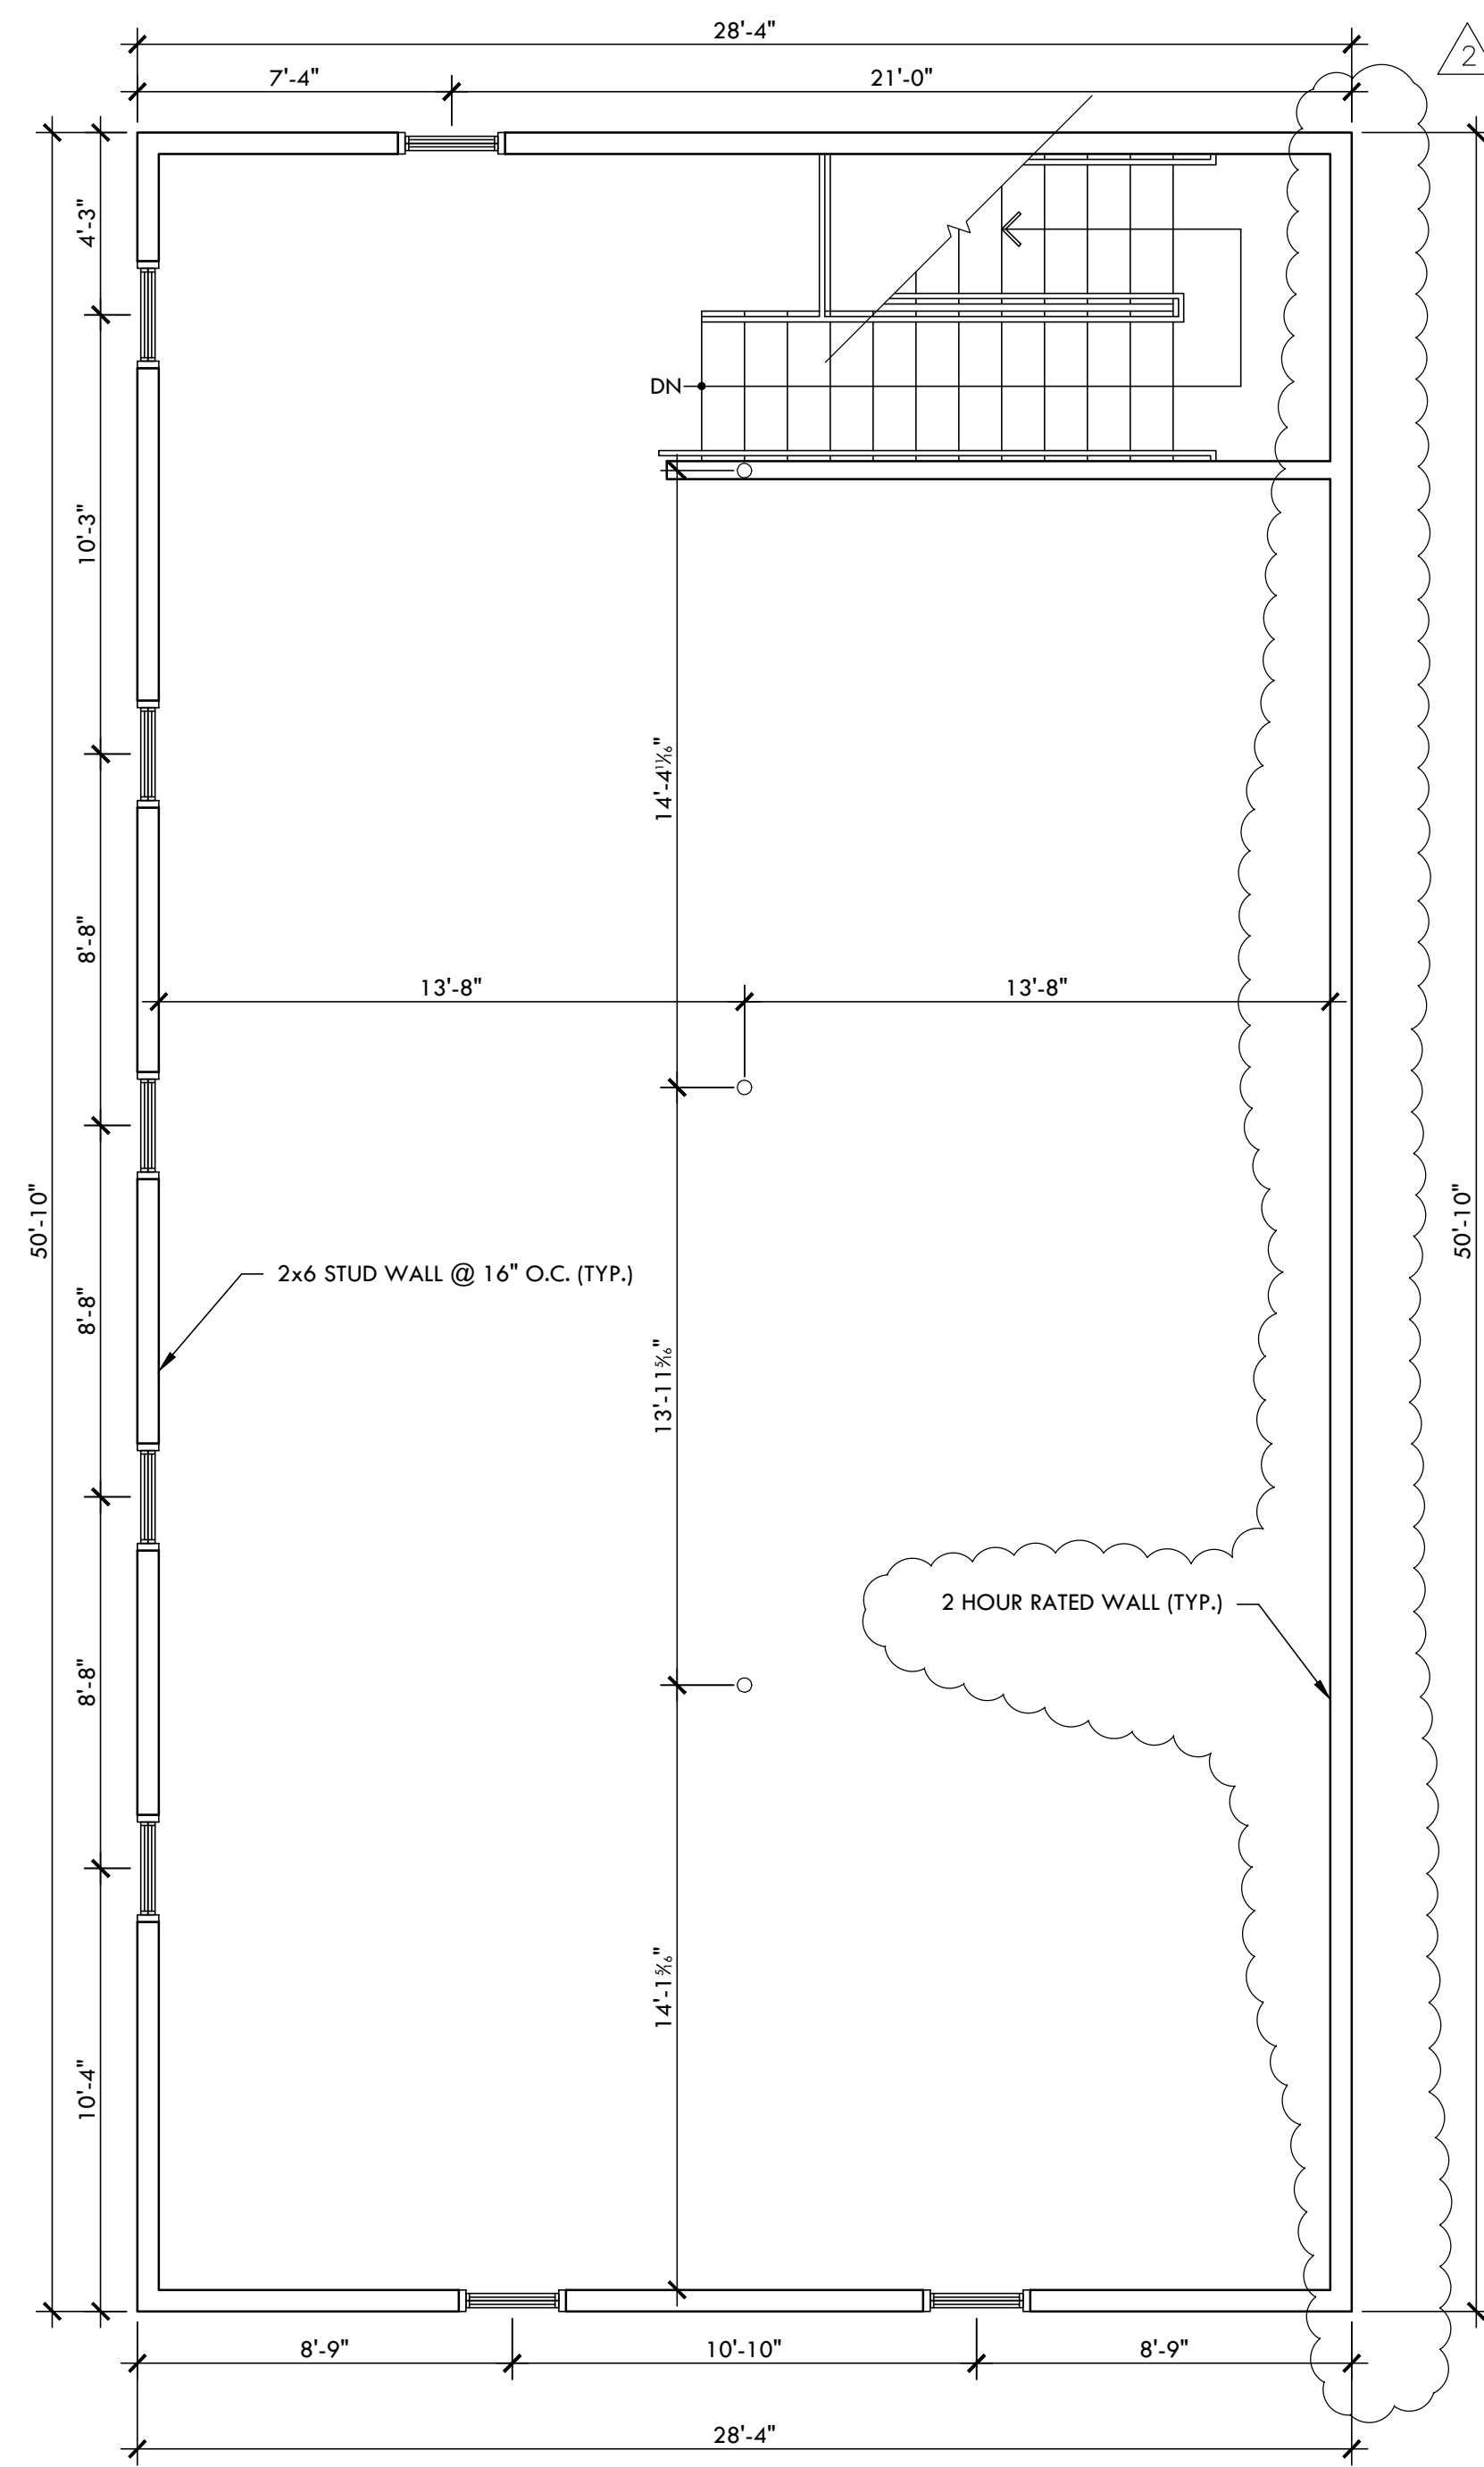

SECOND FLOOR PLAN
SCALE: 1/4" = 1' - 0"

C:\Users\BAC\OneDrive\BAC\2021-103 (WAREHOUSE GARAGE ADDITION)\2021-103 (WAREHOUSE GARAGE ADDITION).DWG (2/27/2021 8:27 AM)

THE INFORMATION AND CONTENT OF THIS PLAN OR DOCUMENT IS THE PROPERTY OF BASE ENGINEERING INC. ANY REPRODUCTION, USE, OR DISCLOSURE OF THE DESIGN OR DETAILS CONTAINED HEREIN IS PROHIBITED WITHOUT THE EXPRESSED WRITTEN AUTHORIZATION OF BASE ENGINEERING INC. COPYRIGHTED © 2008 BASE ENGINEERING INC.

REV	DESCRIPTION	BY	CHK	DATE	REV	DESCRIPTION	BY	CHK	DATE
1	GENERAL REVISIONS REMOVED SECOND FLOOR	TZS	BAC	12/8/2021	2	PER CODE REVIEW COMMENTS	TZS	BAC	12/27/2021

BASE ENGINEERING INC.
 CONSULTING ENGINEERS & SURVEYORS
 1010 N. QUEBEC STREET
 ALLENTOWN, PA 18109
 PHONE: (610) 437-0978
 www.BaseEng.com
 email: BaseEngineering@BaseEng.com



SCALE	AS NOTED	WAREHOUSE GARAGE ADDITION FLOOR PLANS	DWG. No.
DATE			2021-103 ST3.0
DRAWN BY	TZS	709 YEATES STREET	REV. 2
CHECKED BY	BAC	BETHLEHEM, PA	SHEET
			3 of 6