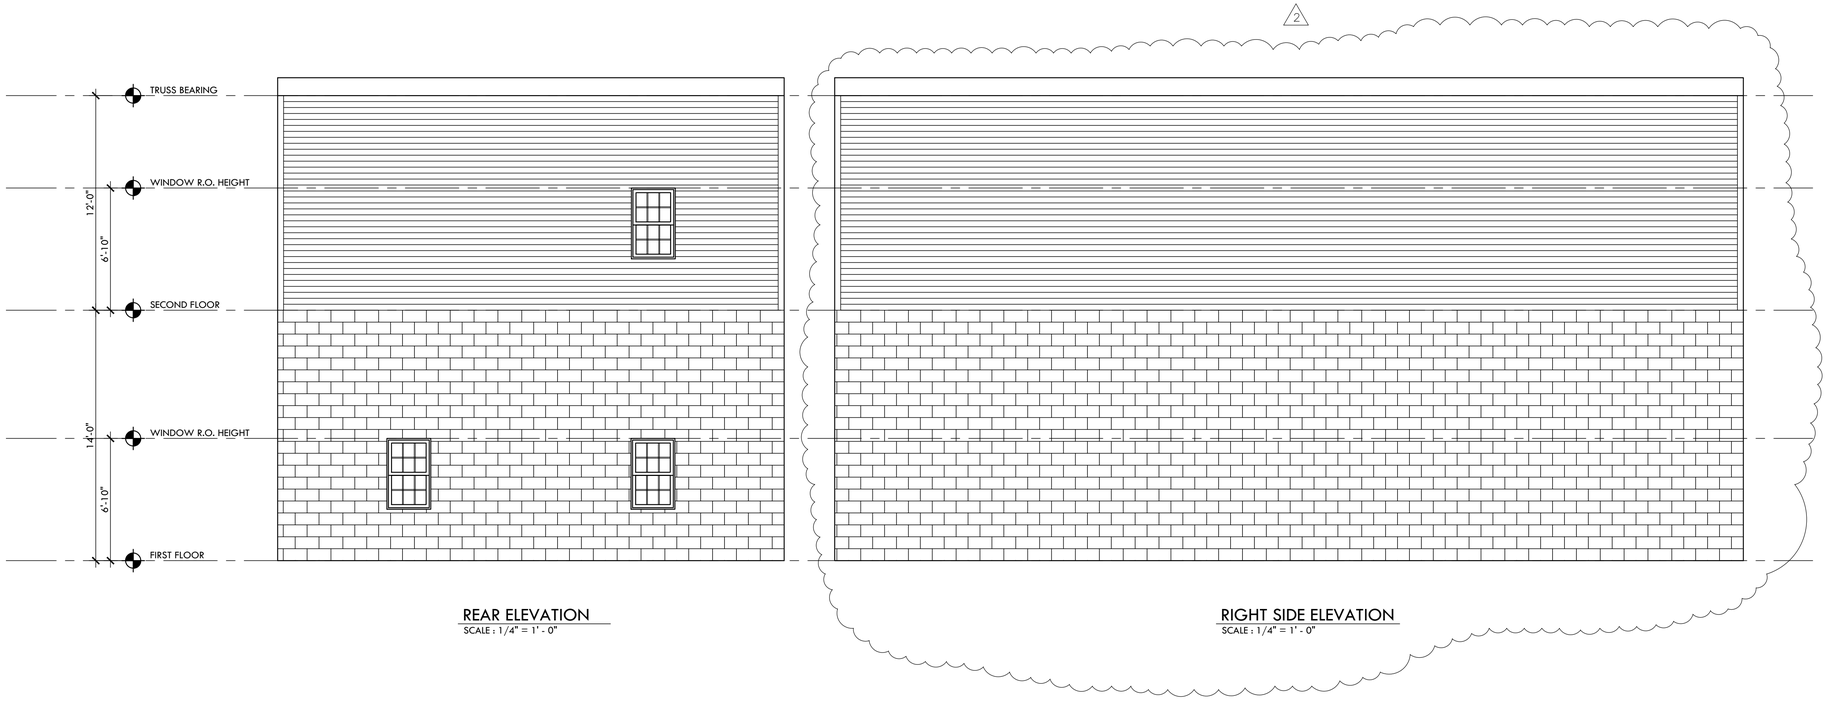

REAR ELEVATION
SCALE : 1/4" = 1' - 0"

RIGHT SIDE ELEVATION
SCALE : 1/4" = 1' - 0"

REV	DESCRIPTION	BY	CHK	DATE
2	PER CODE REVIEW COMMENTS	TZS	BAC	12/27/2021
1	GENERAL REVISIONS REMOVED SECOND FLOOR	TZS	BAC	12/8/2021

THE INFORMATION AND CONTENT OF THIS PLAN OR DOCUMENT IS THE PROPERTY OF BASE ENGINEERING INC. ANY REPRODUCTION, USE, OR DISCLOSURE OF THE DESIGN OR DETAILS CONTAINED HEREIN IS PROHIBITED WITHOUT THE EXPRESSED WRITTEN AUTHORIZATION OF BASE ENGINEERING INC.
COPYRIGHTED © 2008 BASE ENGINEERING INC.

BASE ENGINEERING INC.
CONSULTING ENGINEERS & SURVEYORS
1010 N. QUEBEC STREET
ALLENTOWN, PA 18109
PHONE: (610) 437-0978
www.BaseEng.com
email: BaseEngineering@BaseEng.com

SCALE	AS NOTED
DATE	
DRAWN BY	TZS
CHECKED BY	BAC

WAREHOUSE GARAGE ADDITION
ELEVATIONS
709 YEATES STREET
BETHLEHEM, PA

DWG. No. 2021-103 ST6.0
REV. 2
SHEET 6 of 6

C:\USERS\SHEAR\DROPBOX\BASE\2021-103 (WAREHOUSE GARAGE ADDITION)\2021-12-27 2021-103 (WAREHOUSE GARAGE ADDITION), ST6.0 (24X36)
PLOTTED: 12/27/2021 9:30 AM